







REVISIONS				
REV	DESCRIPTION	DATE	DRAWN	APPR
0	AS BUILT	03/08/13	SS	SS

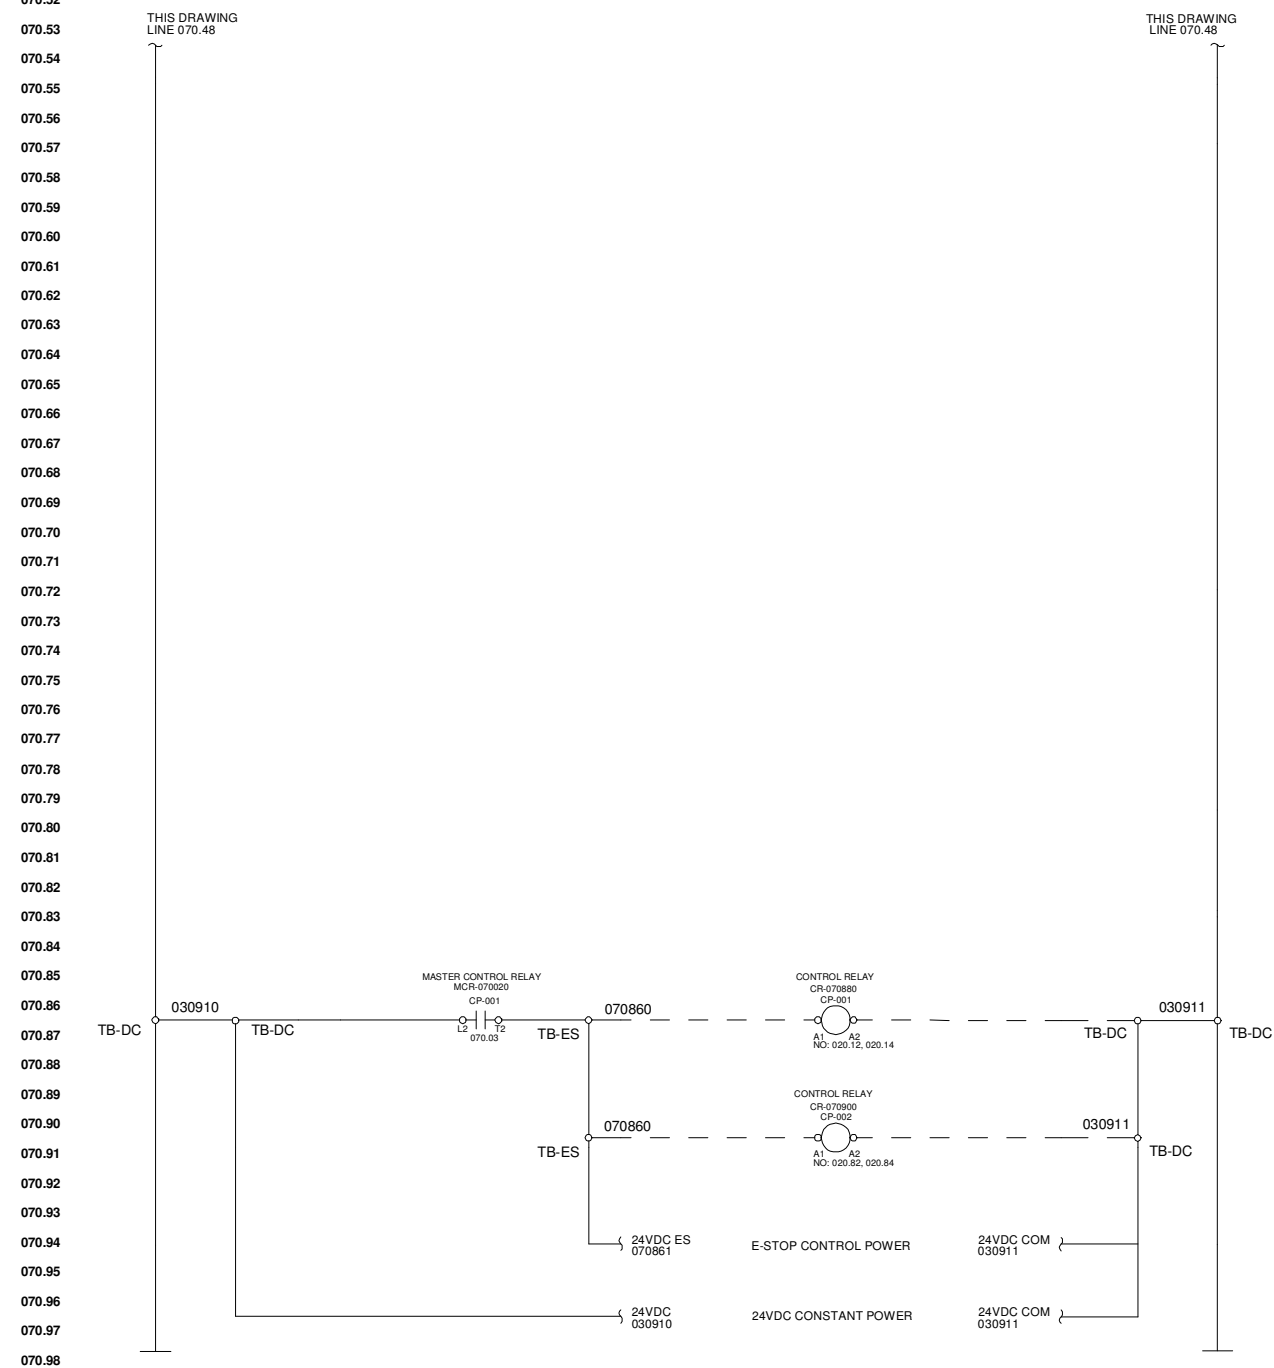


NOTES

- NOTES
1. ALL PANEL WIRING TO BE #16 AWG AND SIS TYPE UNLESS SPECIFIED.
 2. ALL 24VDC WIRING IS BLUE FOR 24VDC AND PINK FOR 24COM UNLESS SPECIFIED.

LEGEND

-  GROUND CONNECTION
 PANEL WIRING
 FIELD WIRING
 TERMINALS CP-001
 TERMINALS CP-002

UNLESS OTHERWISE SPECIFIED	SIGNATURES		DATE		 SS SYSTEMS, LLC P.O. Box 235, 269 Church House Hill Lane, Briceville, TN 37710 (865) 426-9728							
DIMENSIONS ARE IN INCHES TOLERANCES ON: 2 PL DECIMALS +/- 3 PL DECIMALS +/- ANGLES +/- FRACTIONS +/-	DRAWN	SS	03/06/13									
	CHECKED	SS	03/07/13									
	APPROVED	SS	03/08/13									
THIS DRAWING CONTAINS PROPRIETARY INFORMATION WHICH IS TO BE HELD CONFIDENTIAL AND MAY NOT BE REPRODUCED OR DISCLOSED TO OTHERS WITHOUT THE PRIOR WRITTEN CONSENT OF S S SYSTEMS, LLC OR DULY AUTHORIZED REPRESENTATIVE THEREOF.	PROJ ENGR		SS		CLIENT NAME WITHHELD BRIDGE PORT SERIES II CNC RETROFIT SAFETY CIRCUIT CATAGORY B							
	PROJ MGR		SS									
	USE CLIENT DWG NO								SIZE	CAGE CODE	DWG NO.	REV
	N/A								D	n/a	13SS010-070-SAF	0
					SCALE	n/a	PROJECT NO.	13SS010	SHEET	5	OF	10